




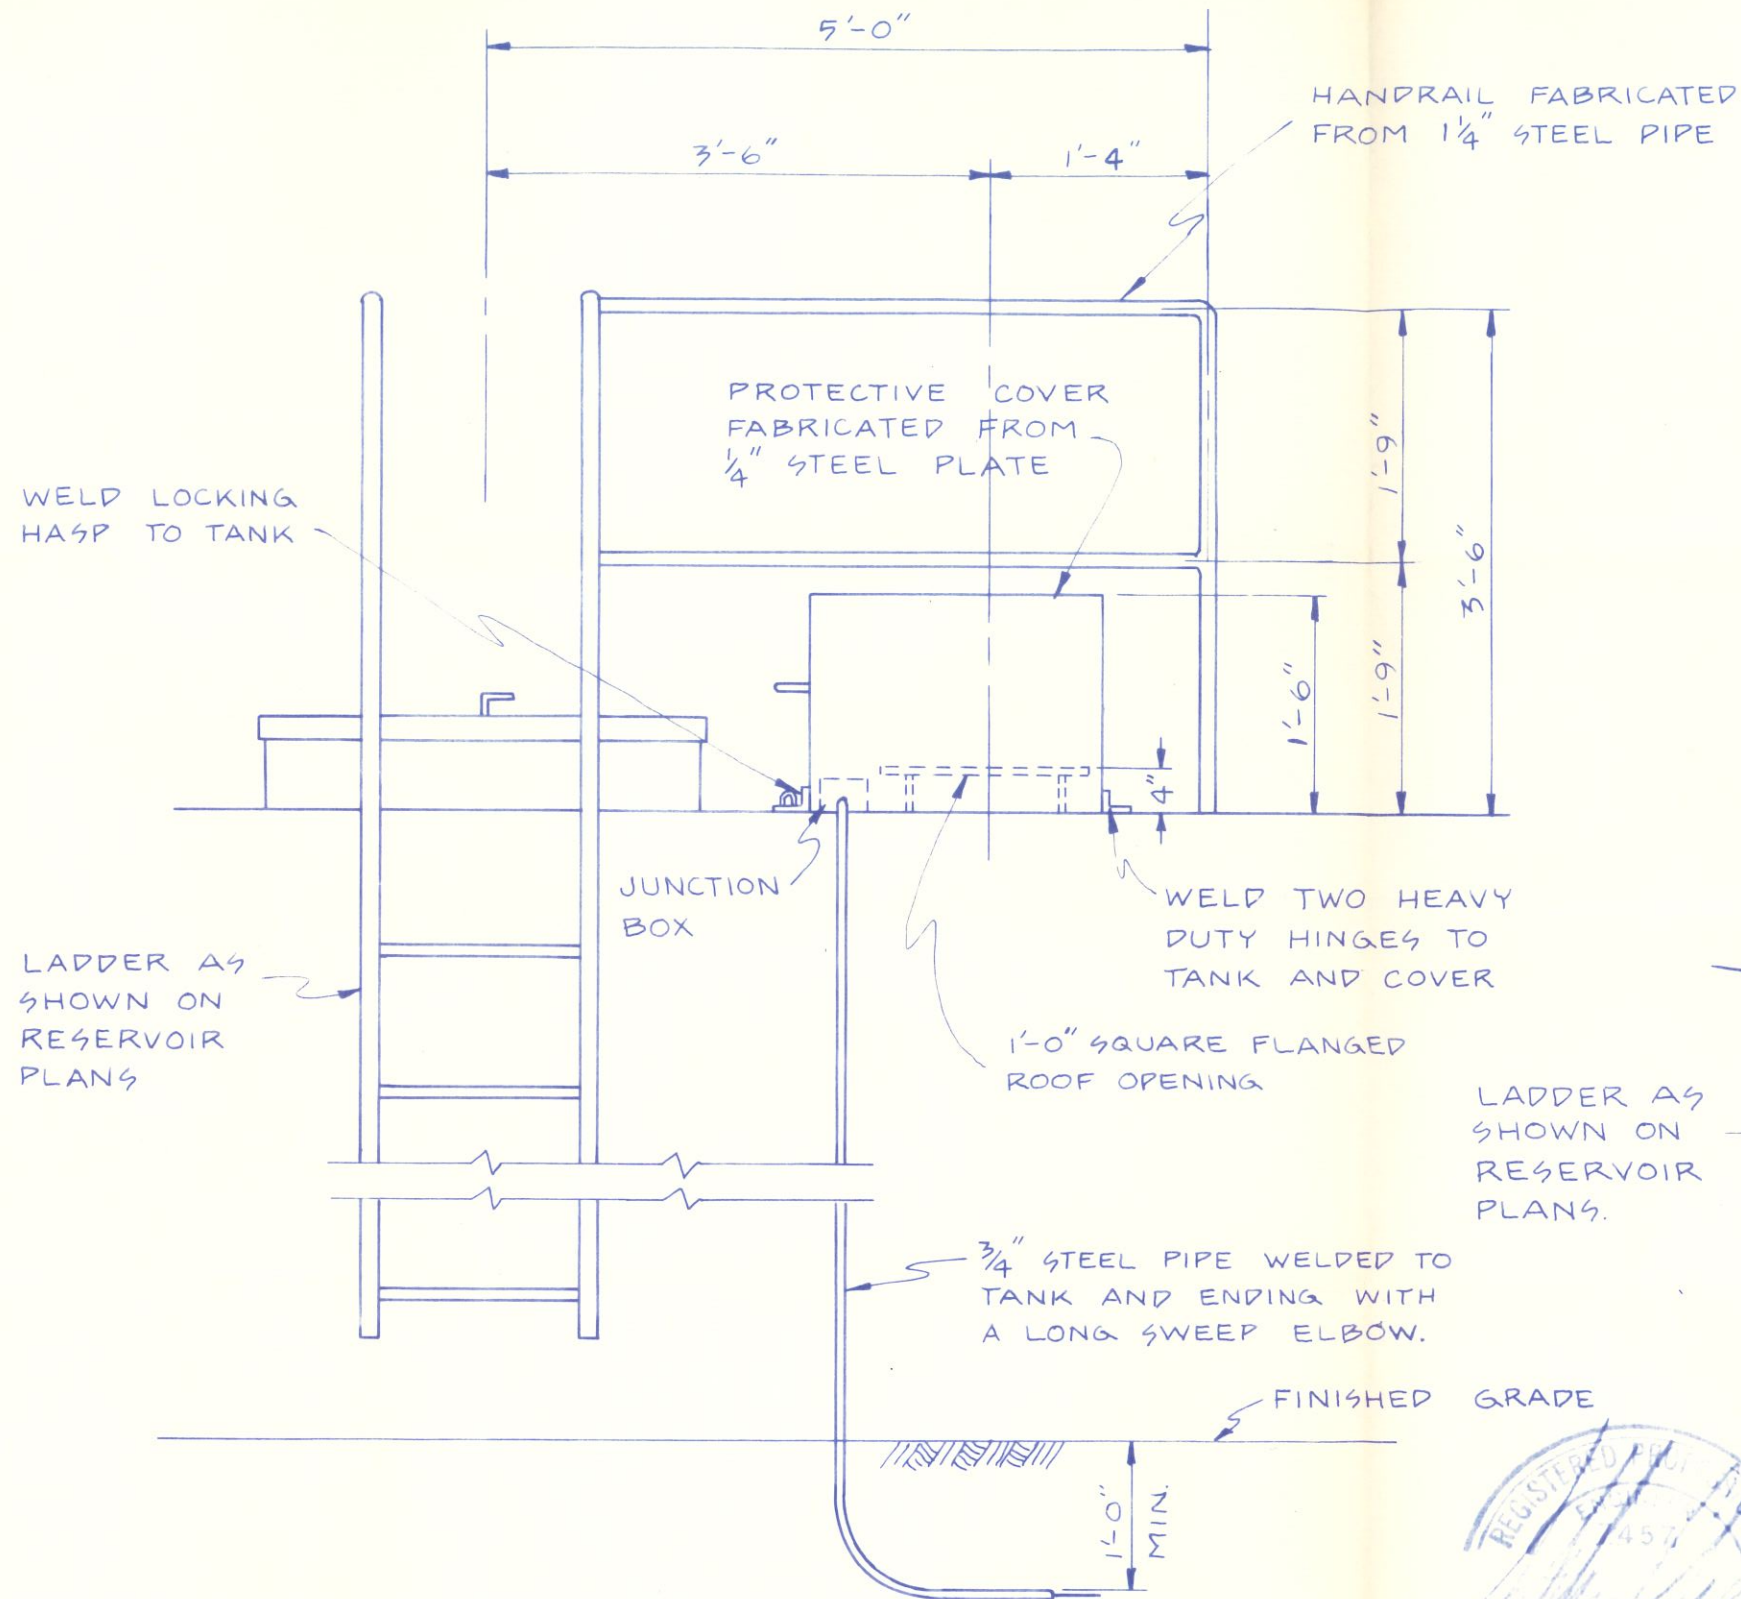

COVERED ROOF OPENING DETAIL
ELEVATION VIEW

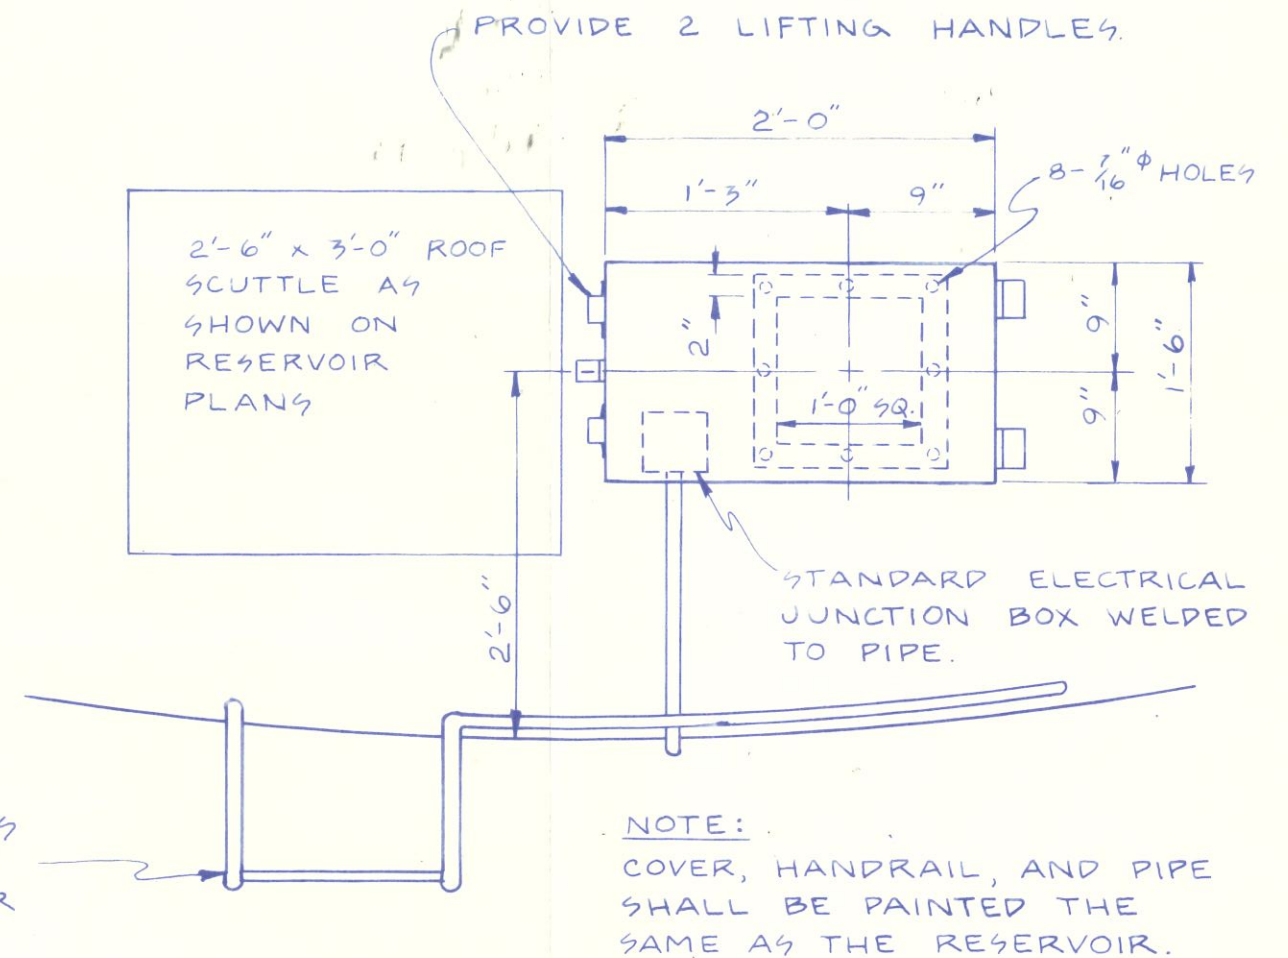

PLAN VIEW

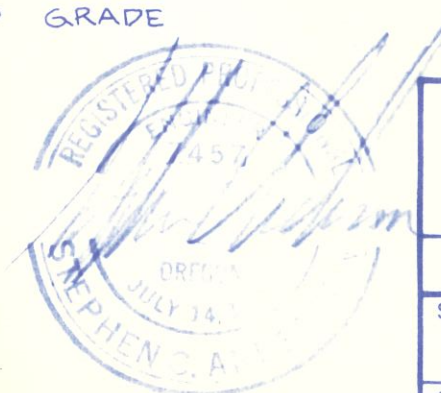

CITY OF ELGIN WATER SYSTEM IMPROVEMENTS PHASE I		
CONTRACT CHANGE ORDER NO. 1		
SCALE: NONE	STEPHEN C. ANDERSON AND ASSOCIATES LA GRANDE, OREGON	SHEET NO. 1-A
DATE: FEB. '75		

CONTRACT CHANGE ORDER

Phase 1, 1,000,000 Gallon Reservoir

CONTRACT FOR

ORDER NO.

1

DATE

April 2, 1975

STATE

Oregon

COUNTY

Union

OWNER

City of Elgin, Oregon

To James E. Baker

Pacific Tank & Construction Corp.

(Contractor)

You are hereby requested to comply with the following changes from the contract plans and specifications:

Description of Changes (Supplemental Plans and Specifications Attached)	DECREASE in Contract Price	INCREASE in Contract Price
1) Handrail, protective cover, 1'-0" square flanged roof opening and 3/4" steel pipe conduit as shown on attached drawing.	\$	\$ 487.00
2) Sections O and P of the "Special Conditions" attached hereto shall be made a part of the Contract Documents.		None
TOTALS	\$	487.00
NET CHANGE IN CONTRACT PRICE	\$	\$ 487.00

JUSTIFICATION:

- 1) Required for Phase 2 Pump Control System.
- 2) Required by Boise Cascade Corporation.

The amount of the Contract will be (~~Decreased~~) (Increased) By The Sum Of: Four Hundred

Eighty Seven and no/100

Dollars (\$ 487.00).

The Contract Total Including this and previous Change Orders Will Be: One hundred Sixty-six

Thousand Four Hundred Eighty-seven and no/100 Dollars (\$ 166,487.00).

The Contract Period Provided for Completion Will Be (~~Increased~~) (~~Decreased~~) (Unchanged): None Days

This document will become a supplement to the contract and all provisions will apply hereto.

Requested Donald D. Scoures (Owner)

4/9/75 (Date)

Recommended Howard E. Dwyer (Owner's Architect/Engineer)

April 3, 1975 (Date)

Accepted James E. Baker (Contractor)

4/11/75 (Date)

Approved By FHA Jerry D. Spindler (Name and Title)

4/16/75 (Date)

Approved by Boise Cascade Corp. Milt Leighes
Name and Title

Manager April 4, 1975
Eng. Date

STEPHEN C. ANDERSON & ASSOCIATES

CONSULTING CIVIL ENGINEERS

SEWER, WATER & IRRIGATION SYSTEMS
ROAD DESIGN, SURVEYS & SUBDIVISIONS
STRUCTURAL DESIGN & INSPECTIONS

STEPHEN C. ANDERSON, P. E.
P. O. Box 1301
LA GRANDE, OREGON 97850
(503) 963-8309

SPECIAL CONDITIONS

The following sections shall be added to the SPECIAL CONDITIONS:

- O. Boise Cascade Corporation is not a party to the Construction Contract and shall have no duty to perform any of the obligations or duties of the "Owner" under the Construction Contract or to guarantee the "Owners" performance of said duties and obligations but instead shall be a third party beneficiary of all of said obligations and duties of the "Contractor".
- P. Boise Cascade Corporation shall approve all change orders before they become effective.